


Dewey Beach MS4 Phase 2

Dewey Beach, DE

Date: 10/6/2023

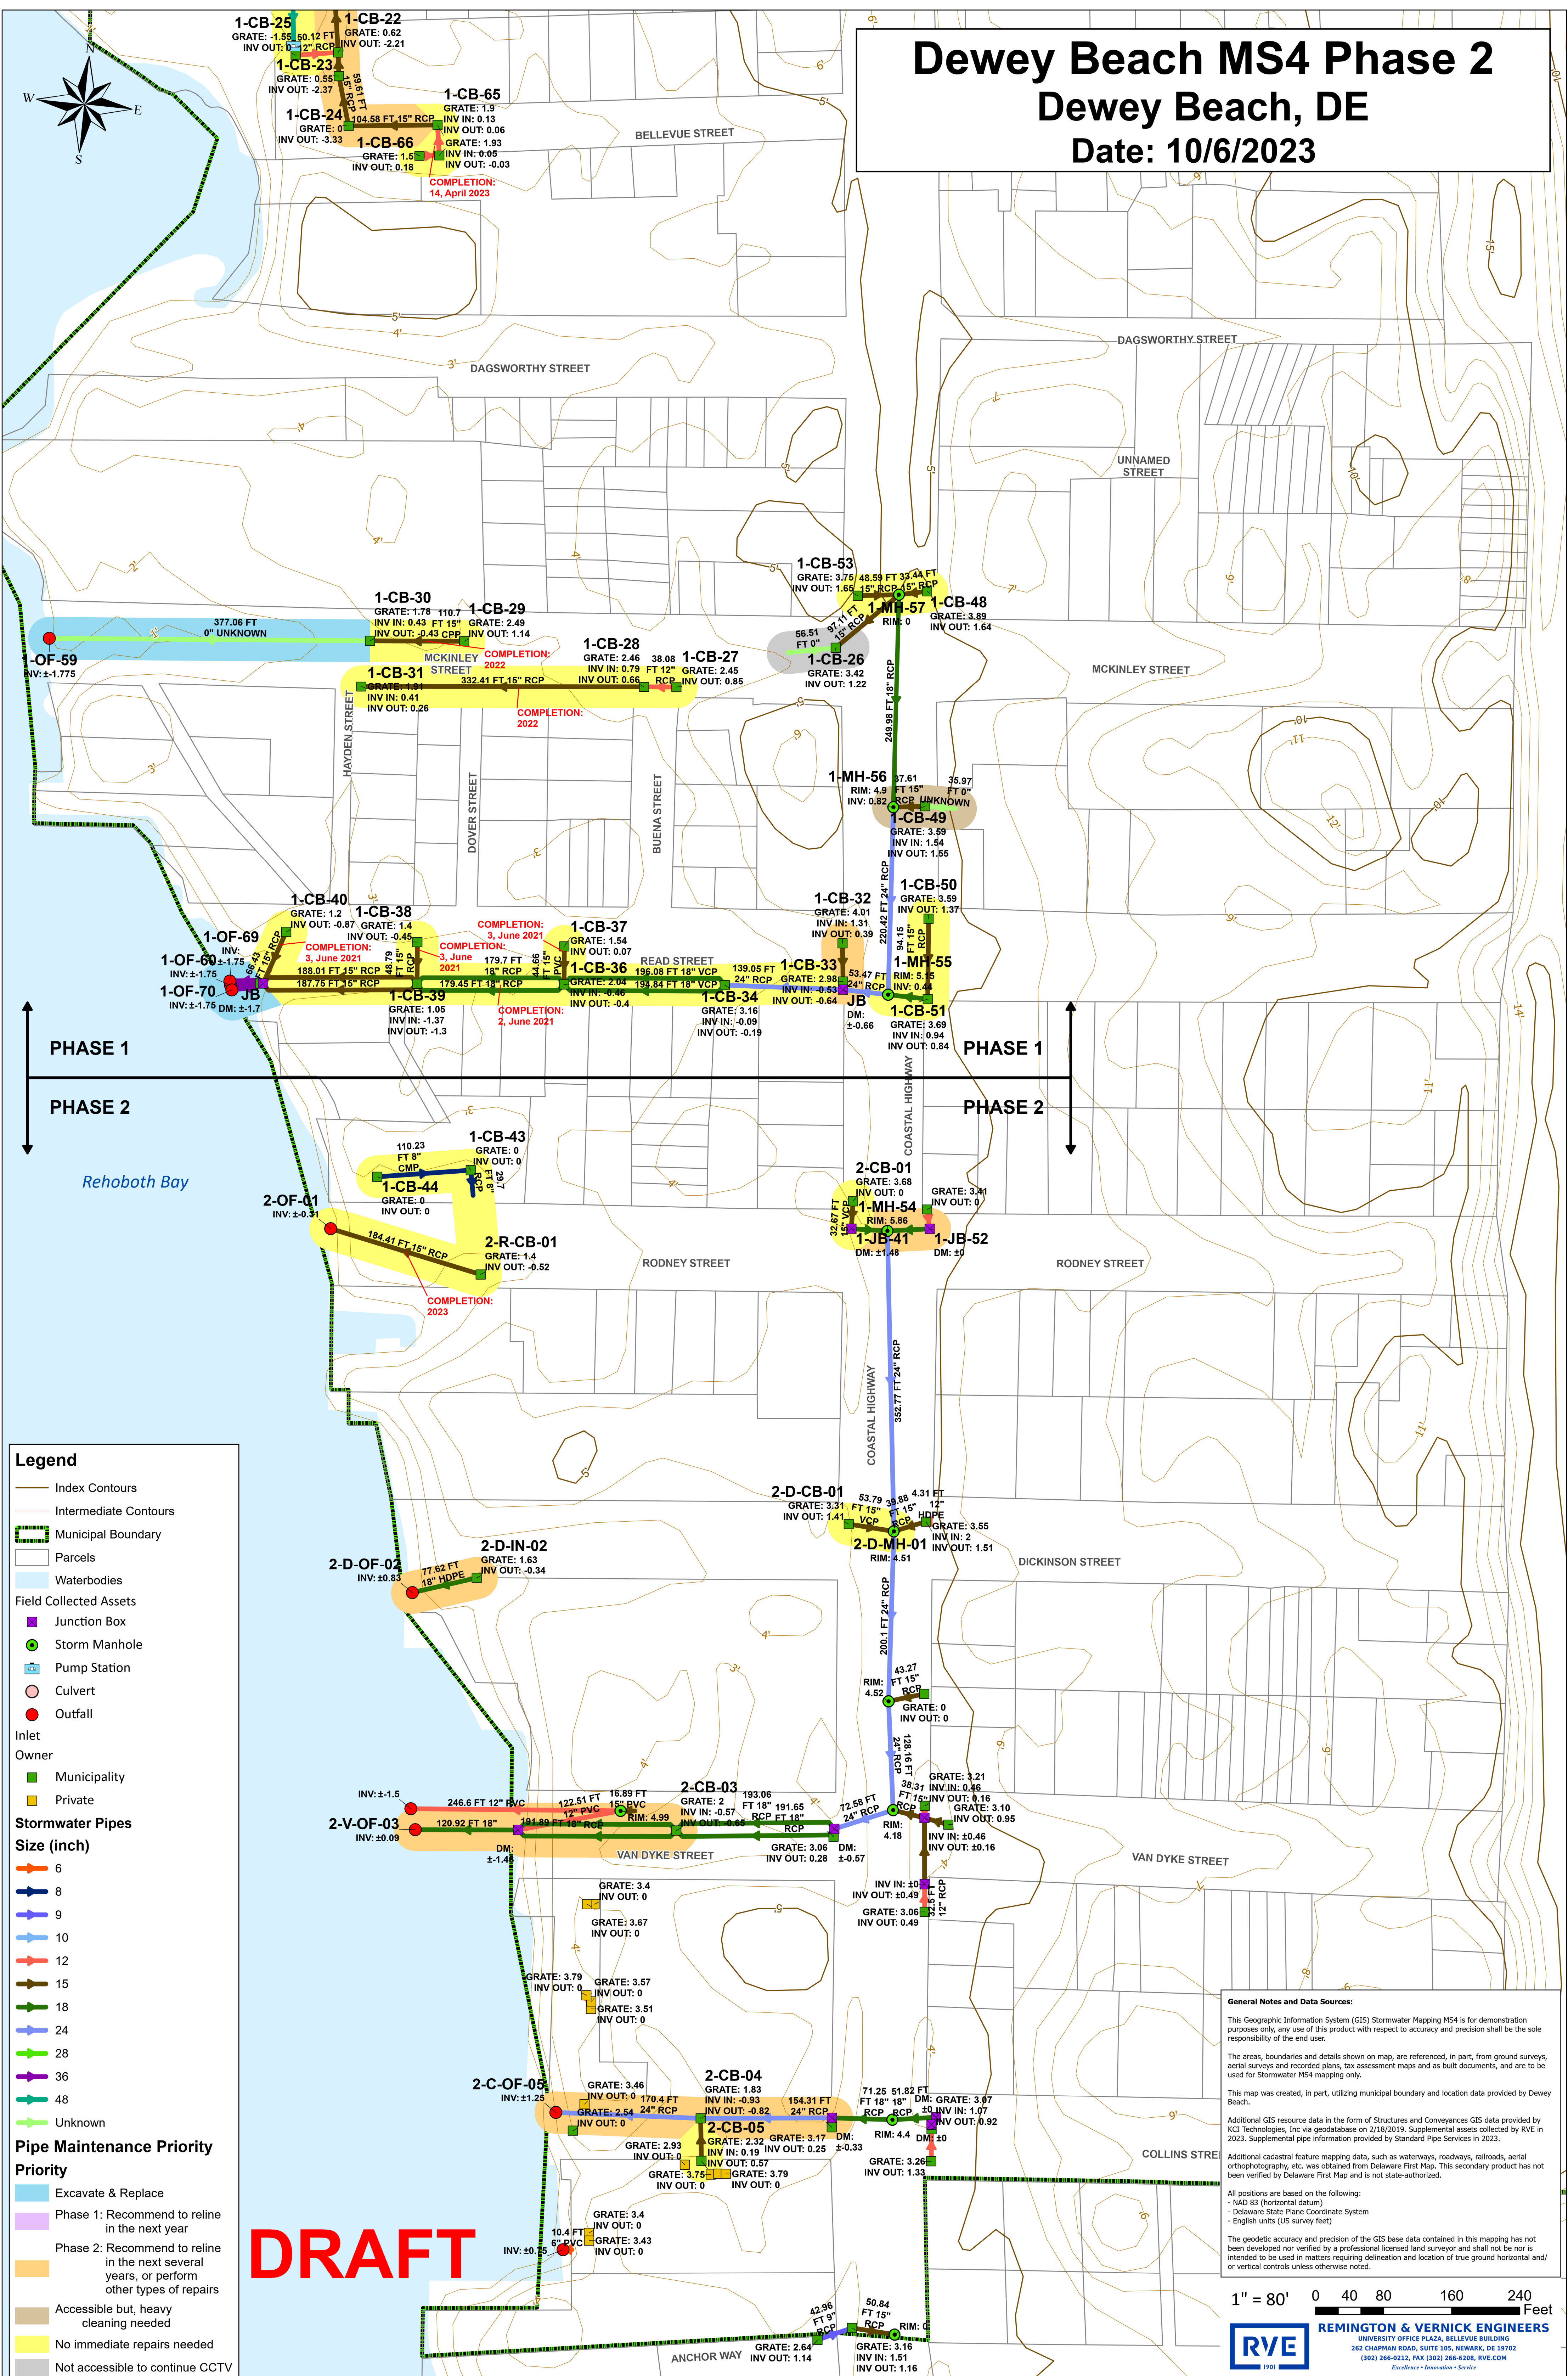

Legend

- Index Contours
- Intermediate Contours
- Municipal Boundary
- Parcels
- Waterbodies

Field Collected Assets

- Junction Box
- Storm Manhole
- Pump Station
- Culvert
- Outfall
- Inlet

Owner

- Municipality
- Private

Stormwater Pipes

Size (inch)

- 6
- 8
- 9
- 10
- 12
- 15
- 18
- 24
- 28
- 36
- 48
- Unknown

Pipe Maintenance Priority

Priority

- Excavate & Replace
- Phase 1: Recommend to reline in the next year
- Phase 2: Recommend to reline in the next several years, or perform other types of repairs
- Accessible but, heavy cleaning needed
- No immediate repairs needed
- Not accessible to continue CCTV

DRAFT

General Notes and Data Sources:

This Geographic Information System (GIS) Stormwater Mapping MS4 is for demonstration purposes only, any use of this product with respect to accuracy and precision shall be the sole responsibility of the end user.

The areas, boundaries and details shown on map, are referenced, in part, from ground surveys, aerial surveys and recorded plans, tax assessment maps and as built documents, and are to be used for Stormwater MS4 mapping only.

This map was created, in part, utilizing municipal boundary and location data provided by Dewey Beach.

Additional GIS resource data in the form of Structures and Conveyances GIS data provided by KCI Technologies, Inc via geodatabase on 2/18/2019. Supplemental assets collected by RVE in 2023. Supplemental pipe information provided by Standard Pipe Services in 2023.

Additional cadastral feature mapping data, such as waterways, roadways, railroads, aerial orthophotography, etc. was obtained from Delaware First Map. This secondary product has not been verified by Delaware First Map and is not state-authorized.

All positions are based on the following:

- NAD 83 (horizontal datum)
- Delaware State Plane Coordinate System
- English units (US survey feet)

The geodetic accuracy and precision of the GIS base data contained in this mapping has not been developed nor verified by a professional licensed land surveyor and shall not be nor is intended to be used in matters requiring delineation and location of true ground horizontal and/or vertical controls unless otherwise noted.

1" = 80' 0 40 80 160 240 Feet

RVE 1901

REMINGTON & VERNICK ENGINEERS
UNIVERSITY OFFICE PLAZA, BELLEVUE BUILDING
262 CHAPMAN ROAD, SUITE 105, NEWARK, DE 19702
(302) 266-0212, FAX (302) 266-6208, RVE.COM
Excellence • Innovation • Service