



UNIT 10
NOT SHOWN

Wooten
1 McKinley Ave
Unit 11
As Built First Floor Plan
7' ceiling height
11/2/2023

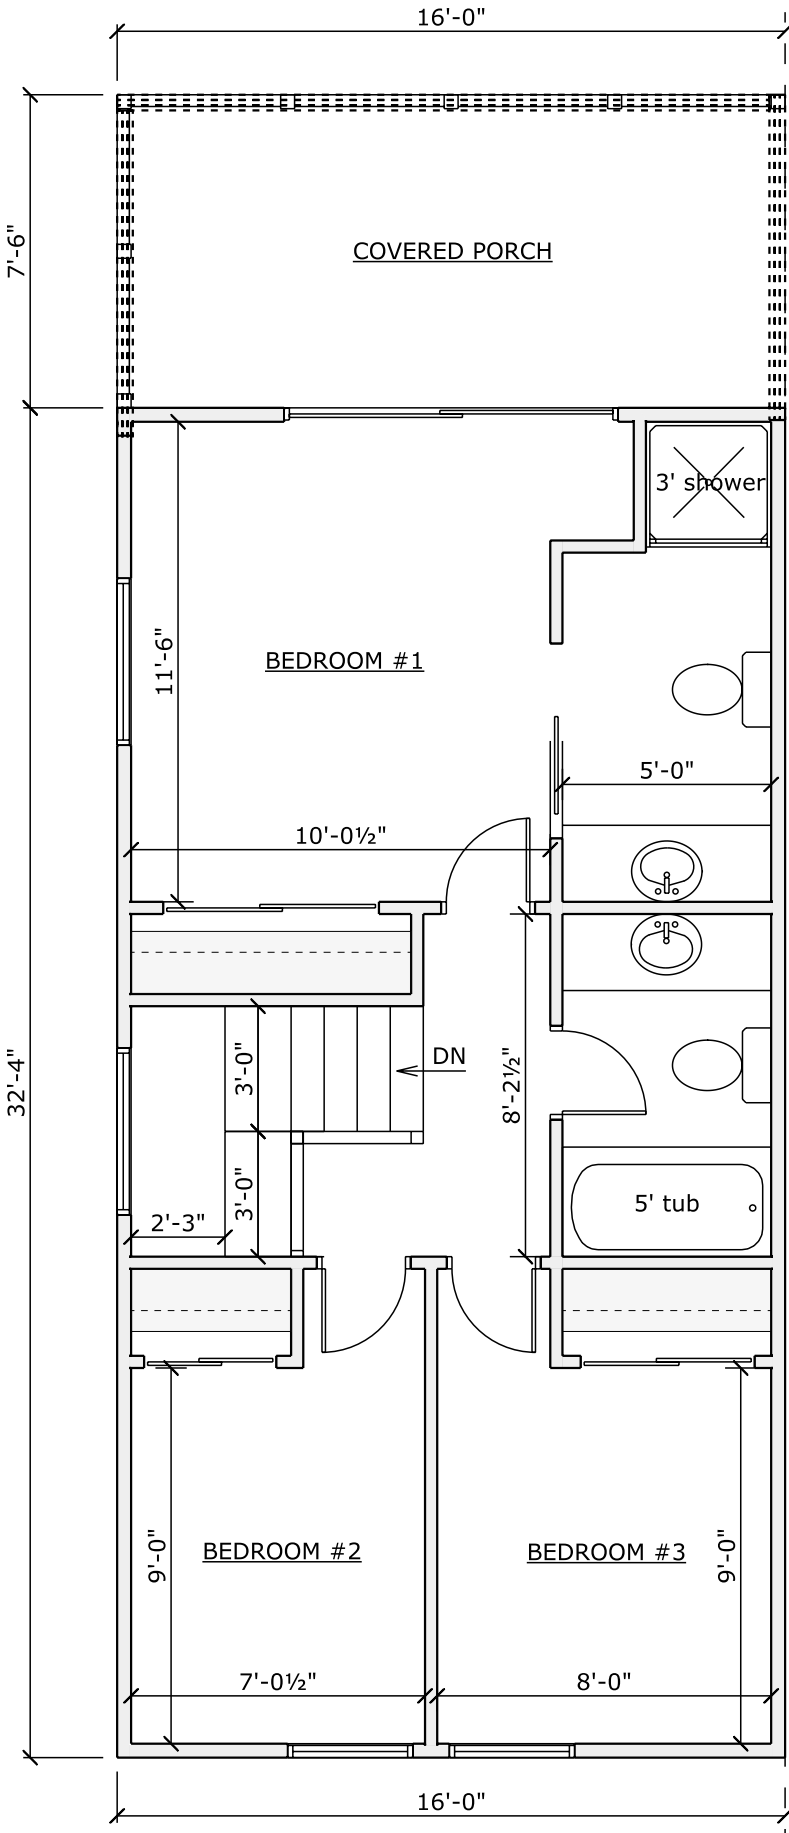


UNIT 10
NOT SHOWN

Wooten
1 McKinley Ave
Unit 11
As Built Second Floor Plan
7' ceiling height
11/2/2023

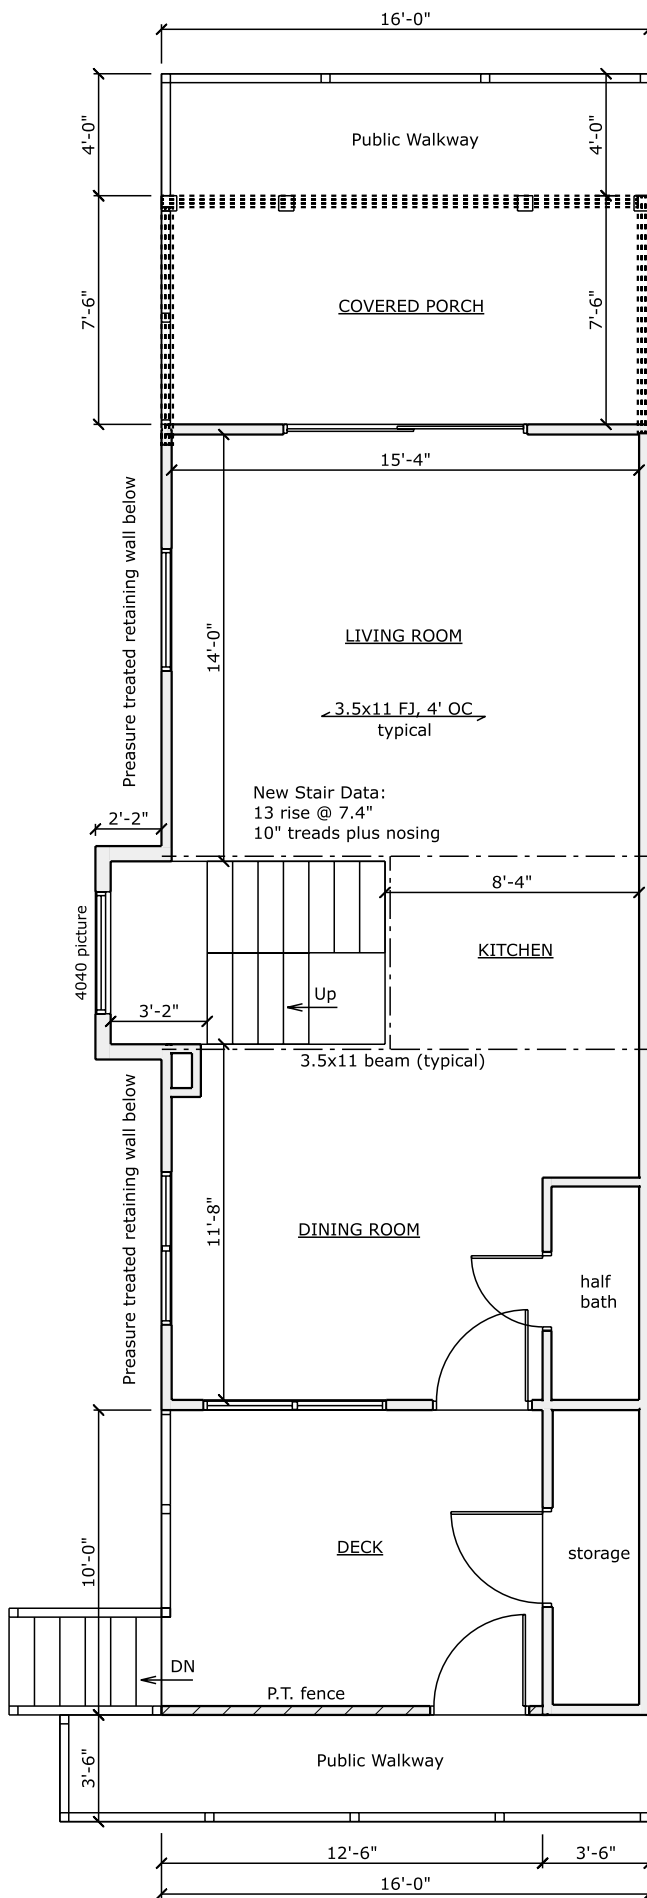


UNIT 10
NOT SHOWN

Wootten
1 McKinley Ave
Unit 11
New First Floor Plan
7' ceiling height
11/2/2023

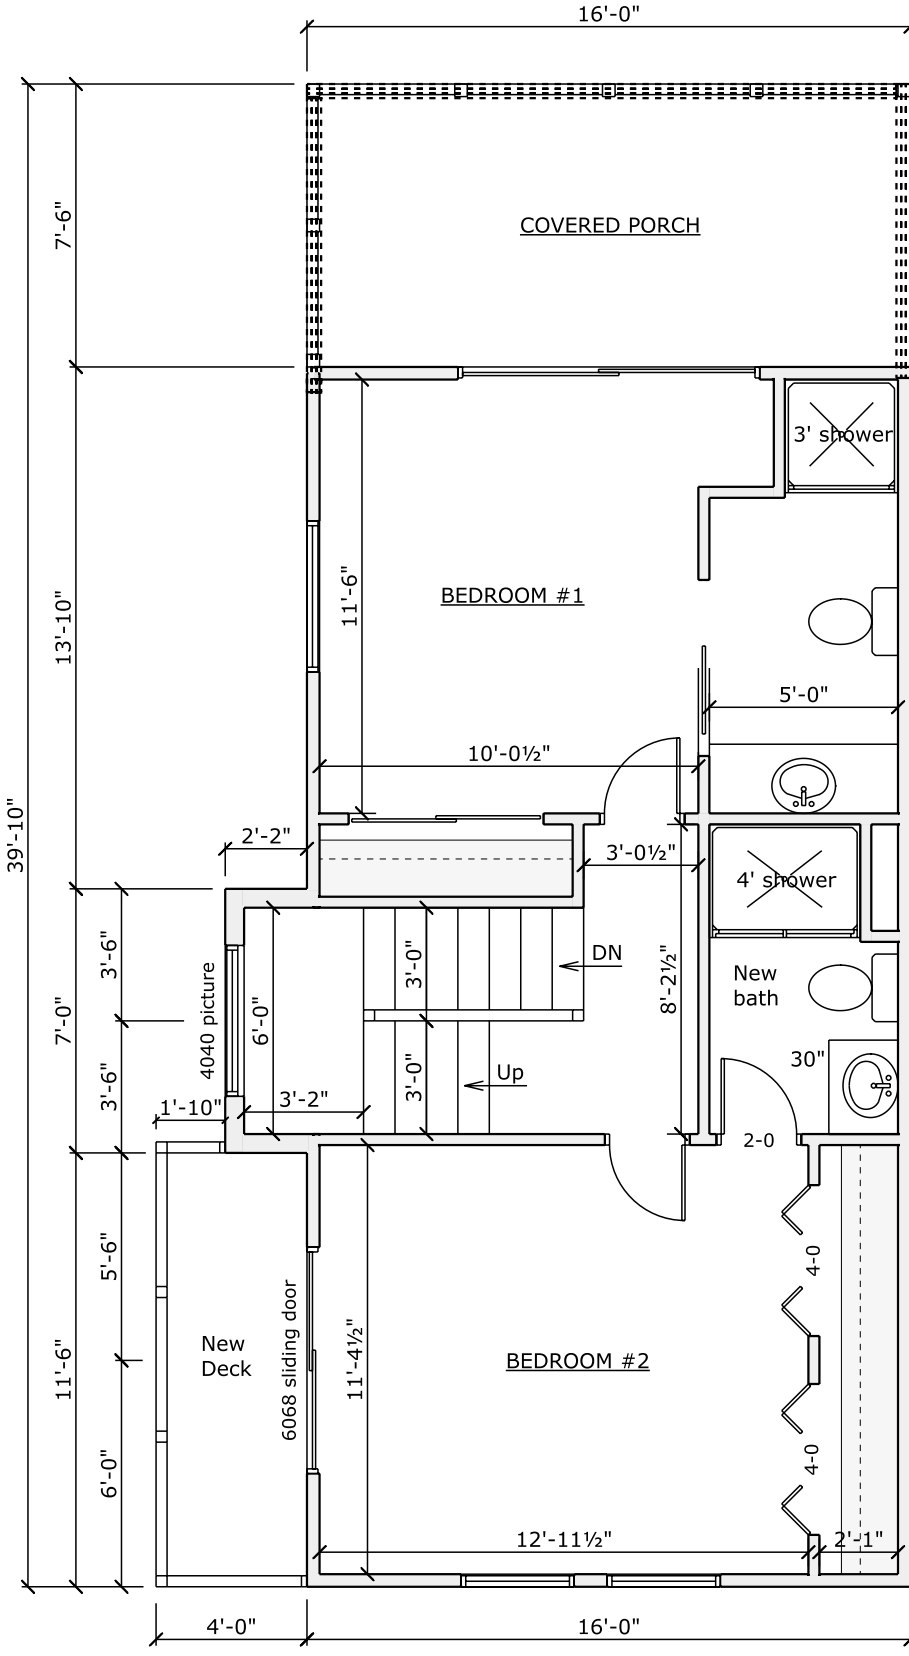


UNIT 10
NOT SHOWN

Wootten
1 McKinley Ave
Unit 11
New Second Floor Plan
7' ceiling height
11/2/2023

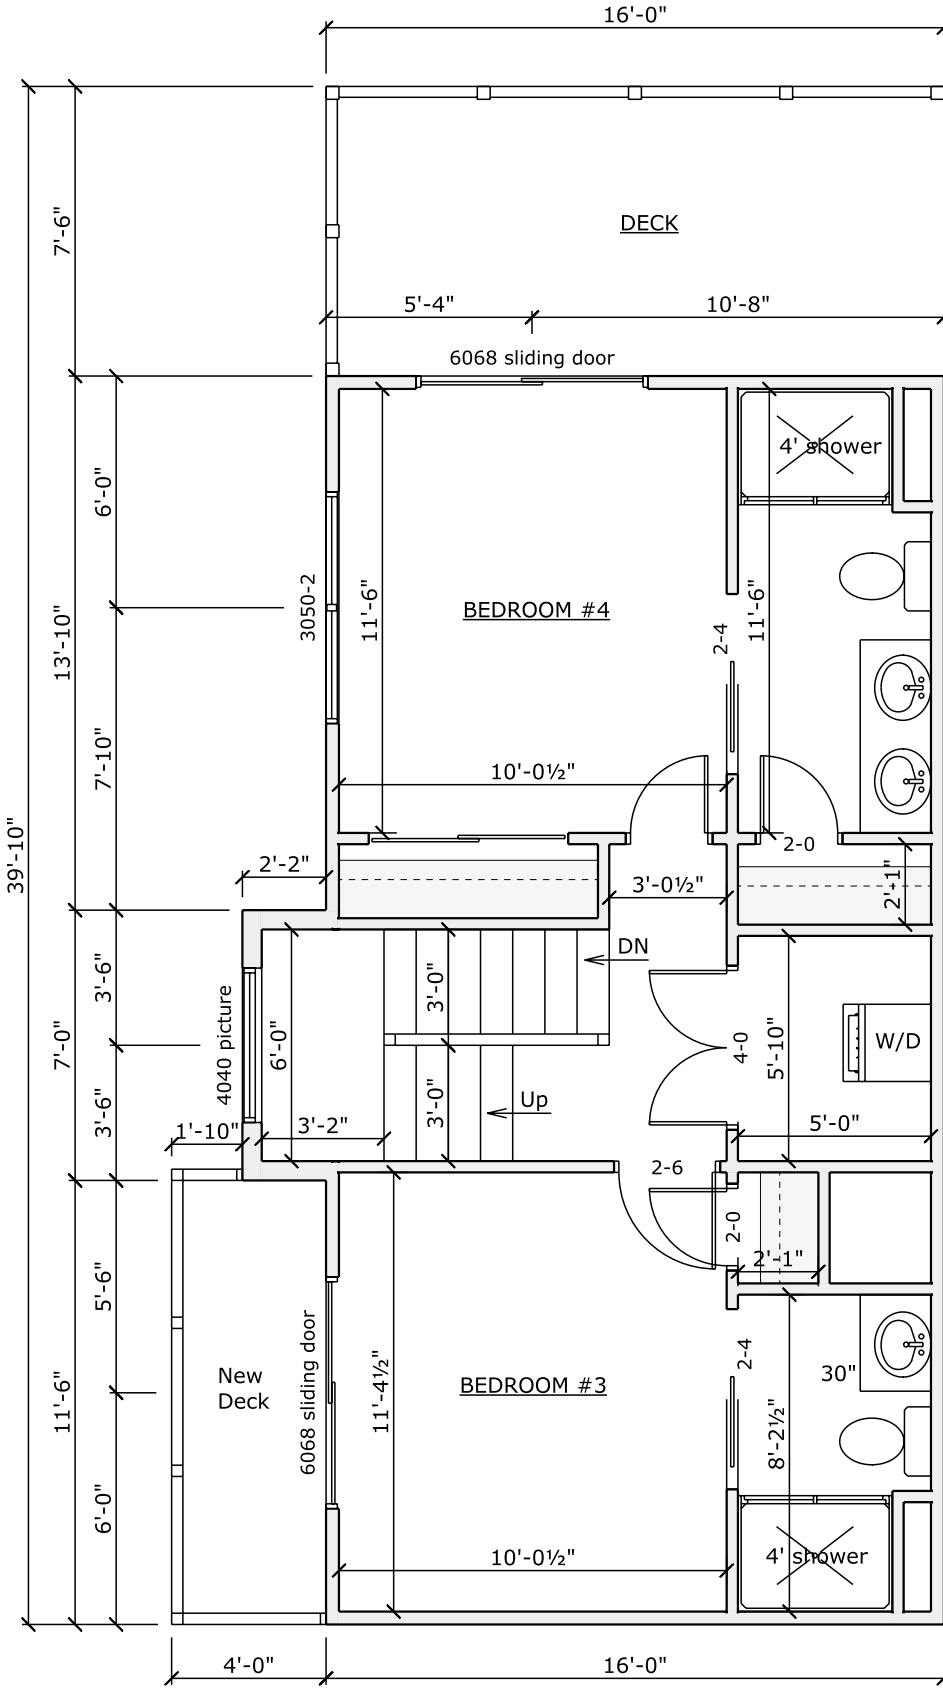

UNIT 10
NOT SHOWN

Wootten
1 McKinley Ave
Unit 11
New Third Floor Plan
7' ceiling height
11/2/2023

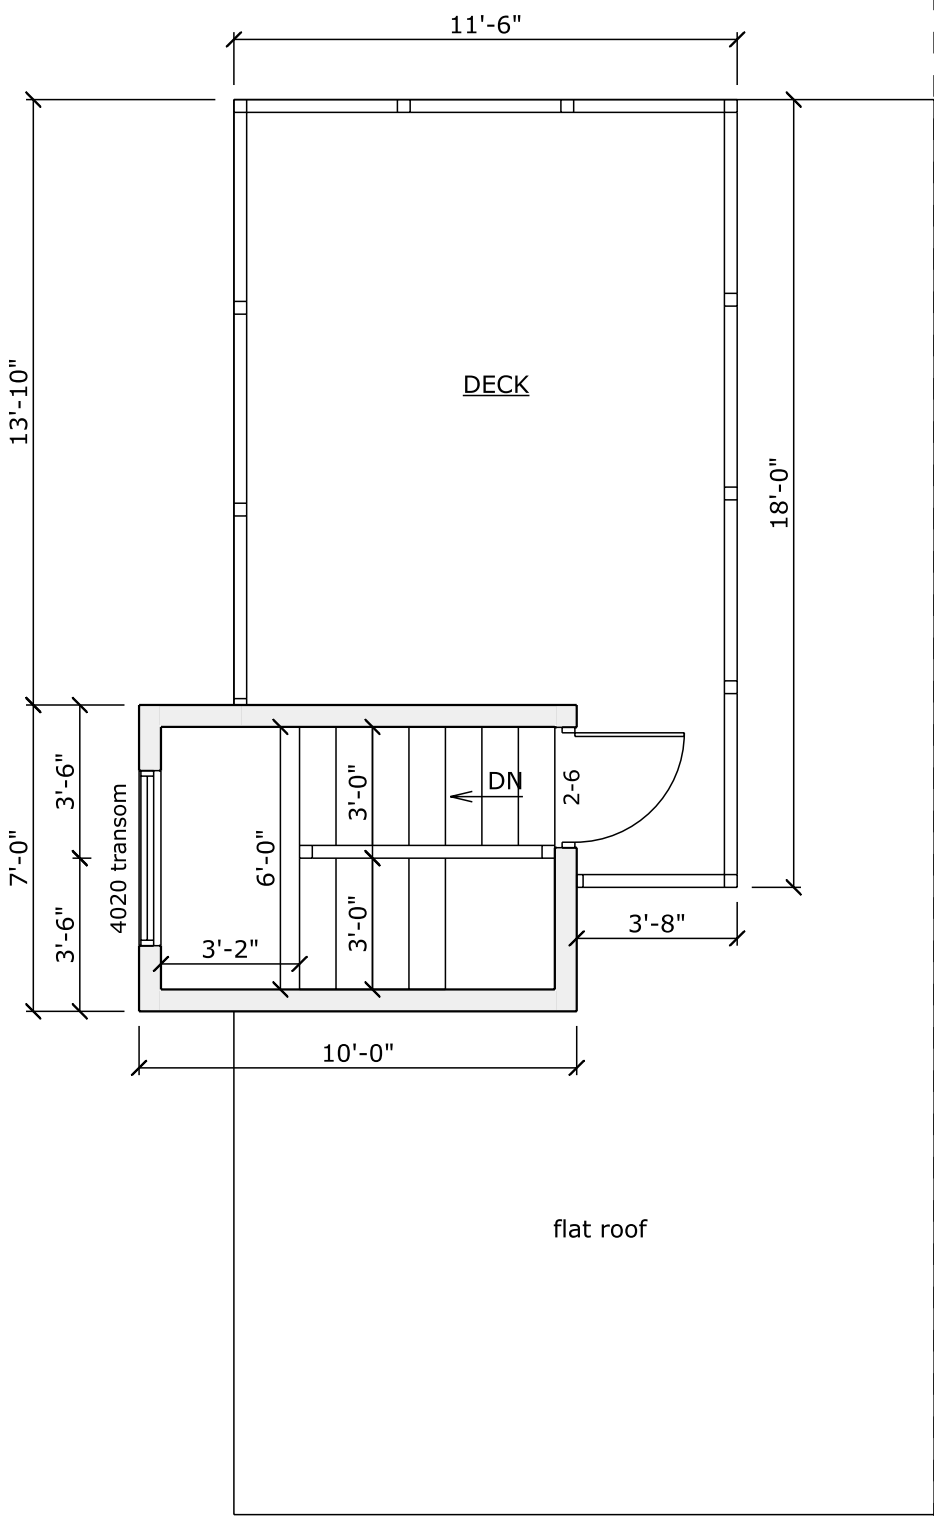

UNIT 10
NOT SHOWN

Wootten
1 McKinley Ave
Unit 11
New Rooftop Deck
7' ceiling height
11/2/2023

