




PROJECT
NORTH

GROUND FLOOR PLAN

SCALE: NOT TO SCALE

REHOBOTH
BAY

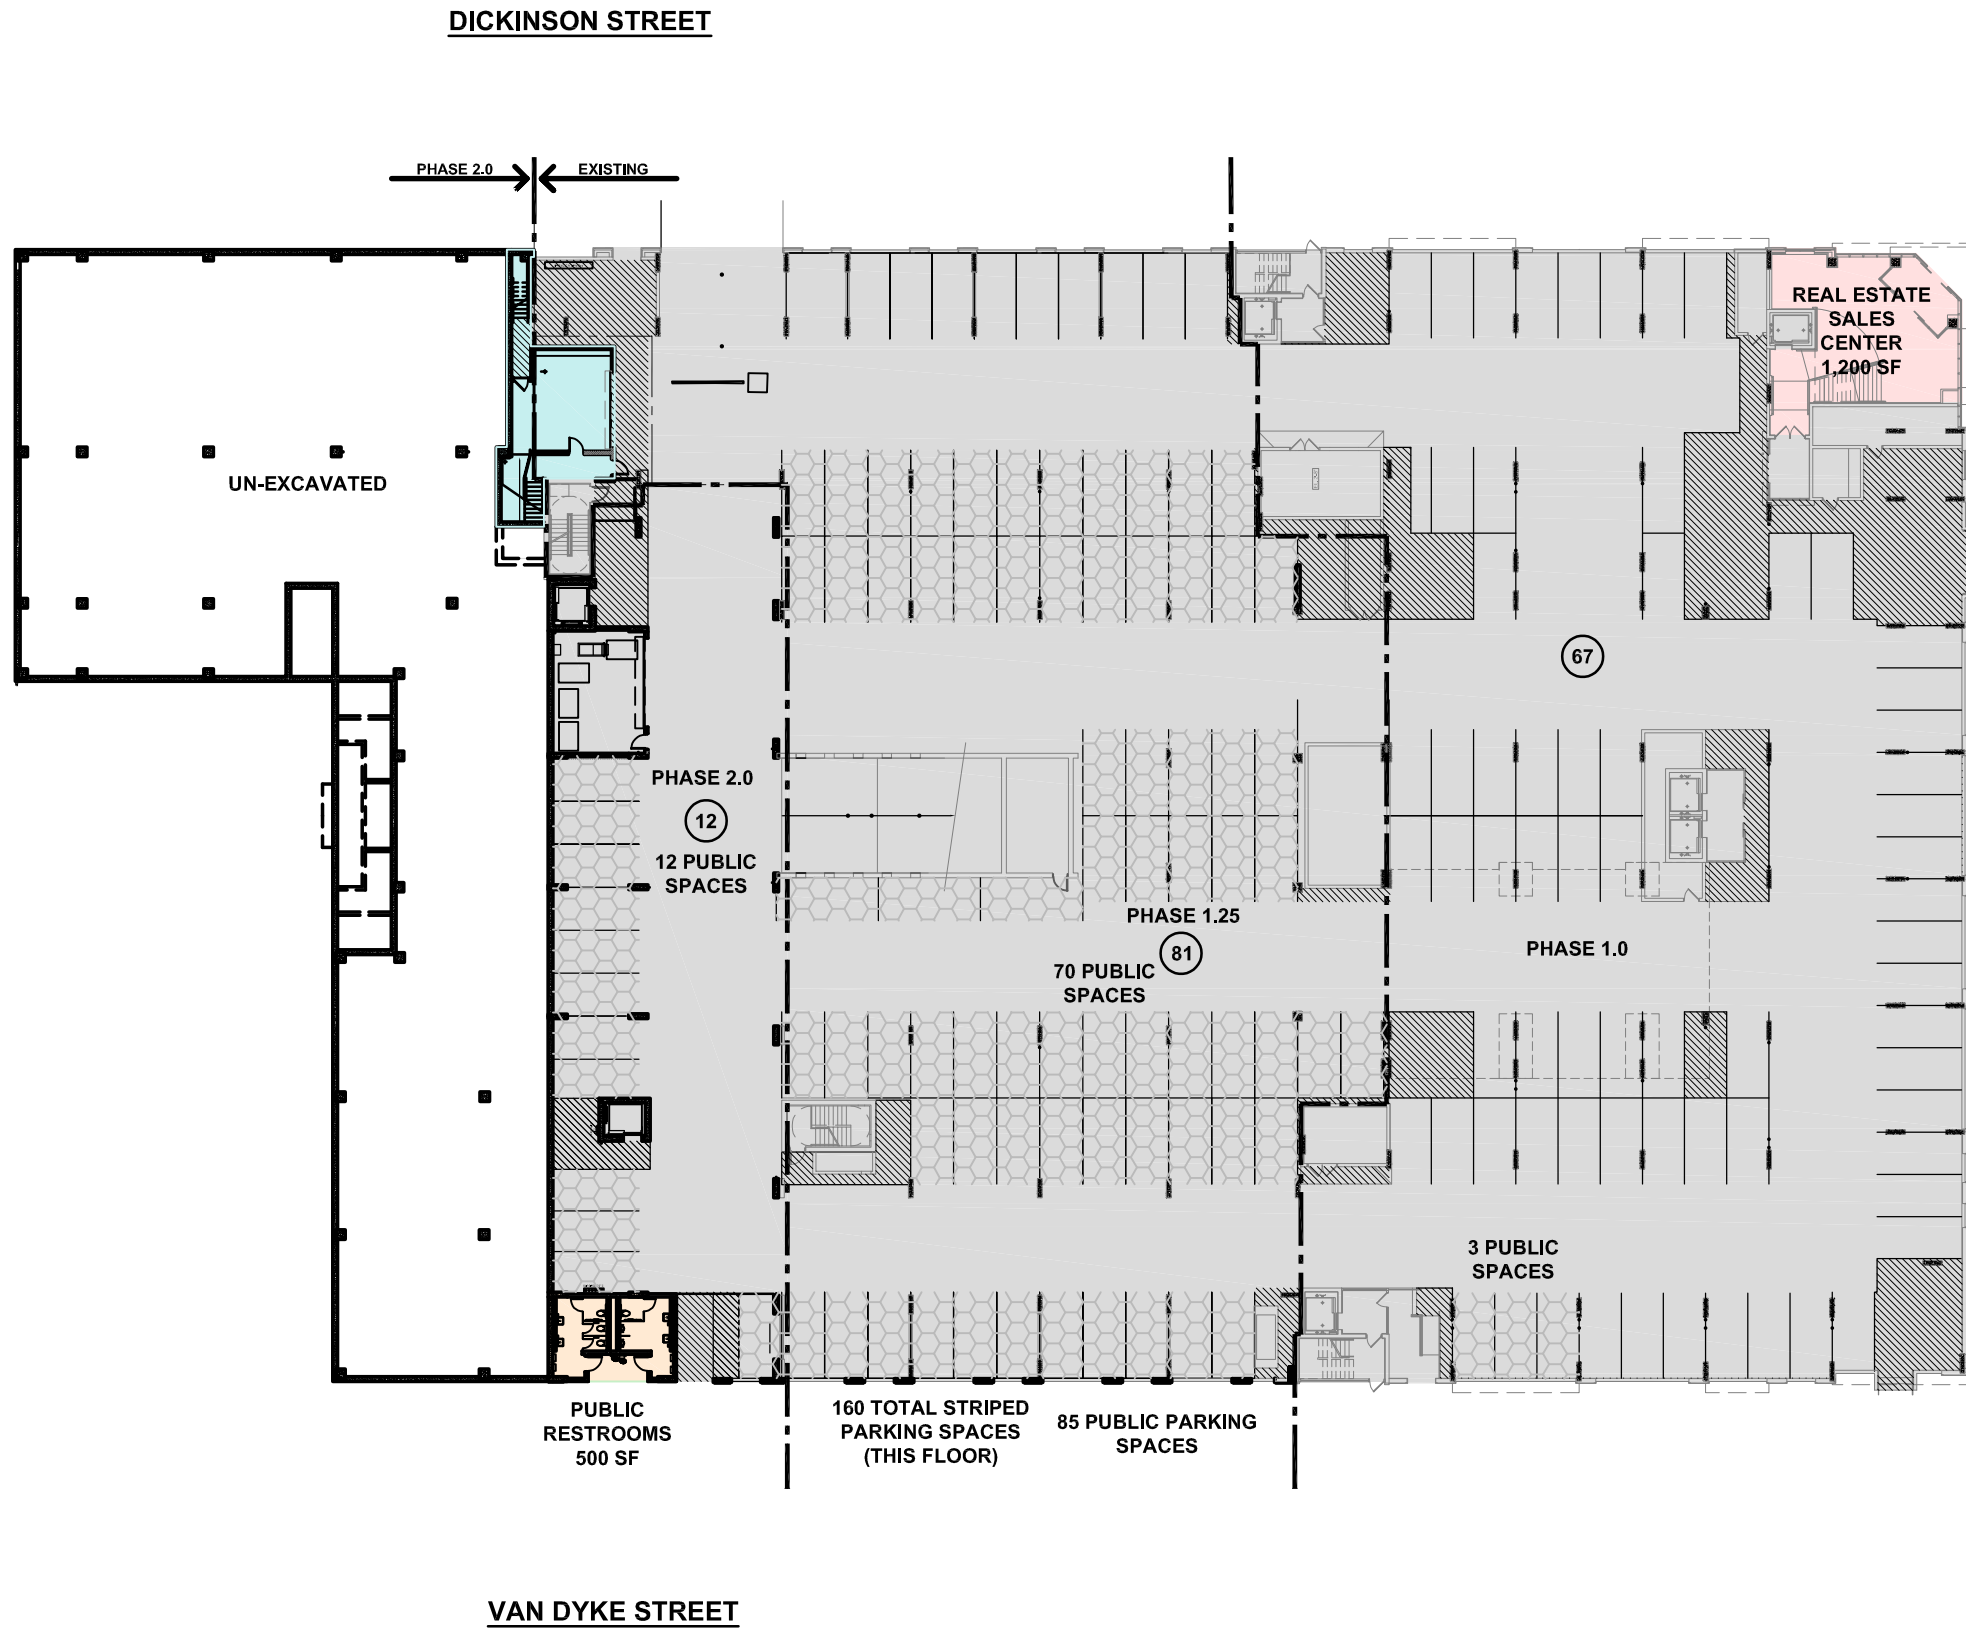

INCLUDES PARKING AS-BUILT

SK-00

PROJECT NUMBER: 11-025
DRAWN BY: M CIHLAR
DATE: OCTOBER 5, 2021
SCALE: AS NOTED

www.arconcepts.com

610.518.1586 T
610.873.1587 F

The Grimmer Mansion
626 West Lincoln Highway
Exton, Pennsylvania 19341

ARCHITECTURAL CONCEPTS, PC

Architecture and Interior Design

Exton · Lancaster · Philadelphia

RUDDERTOWNE

S.E. CORNER DICKINSON ST.
AND COASTAL HIGHWAY
DEWEY BEACH, DE 19971