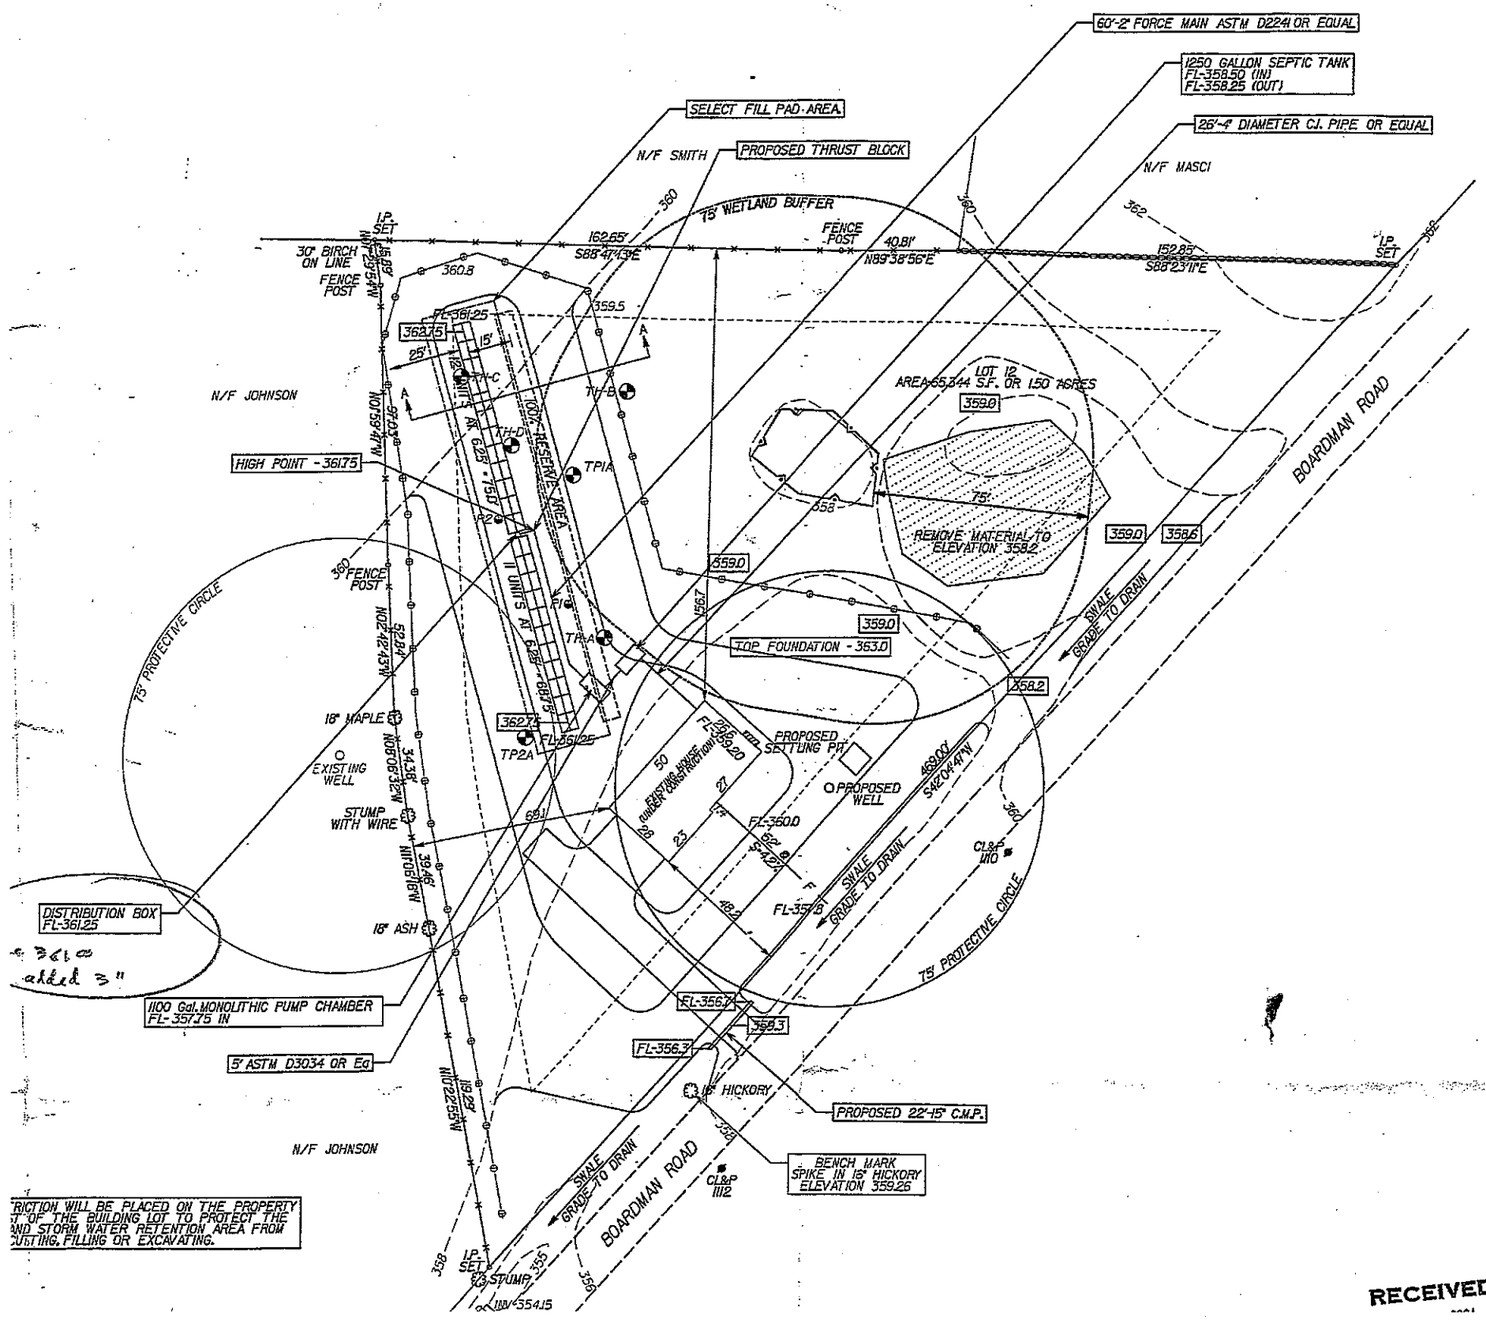


RICTION WILL BE PLACED ON THE PROPERTY
T OF THE BUILDING LOT TO PROTECT THE
ND STORM WATER RETENTION AREA FROM
UTTING, FILLING OR EXCAVATING.

added 3"

CHATHAM HEALTH DISTRICT
APPROVED
Date 4/15/09 By

ZONING LOCATION SURVEY
PRELIMINARY AS BUILT AND SEPTIC LAYOUT MODIFICATIONS
LOT 12
PREPARED FOR
WEST CENTRAL ENTERPRISES, INC.
BOARDMAN ROAD
EAST HADDAM, CONNECTICUT

RECEIVED