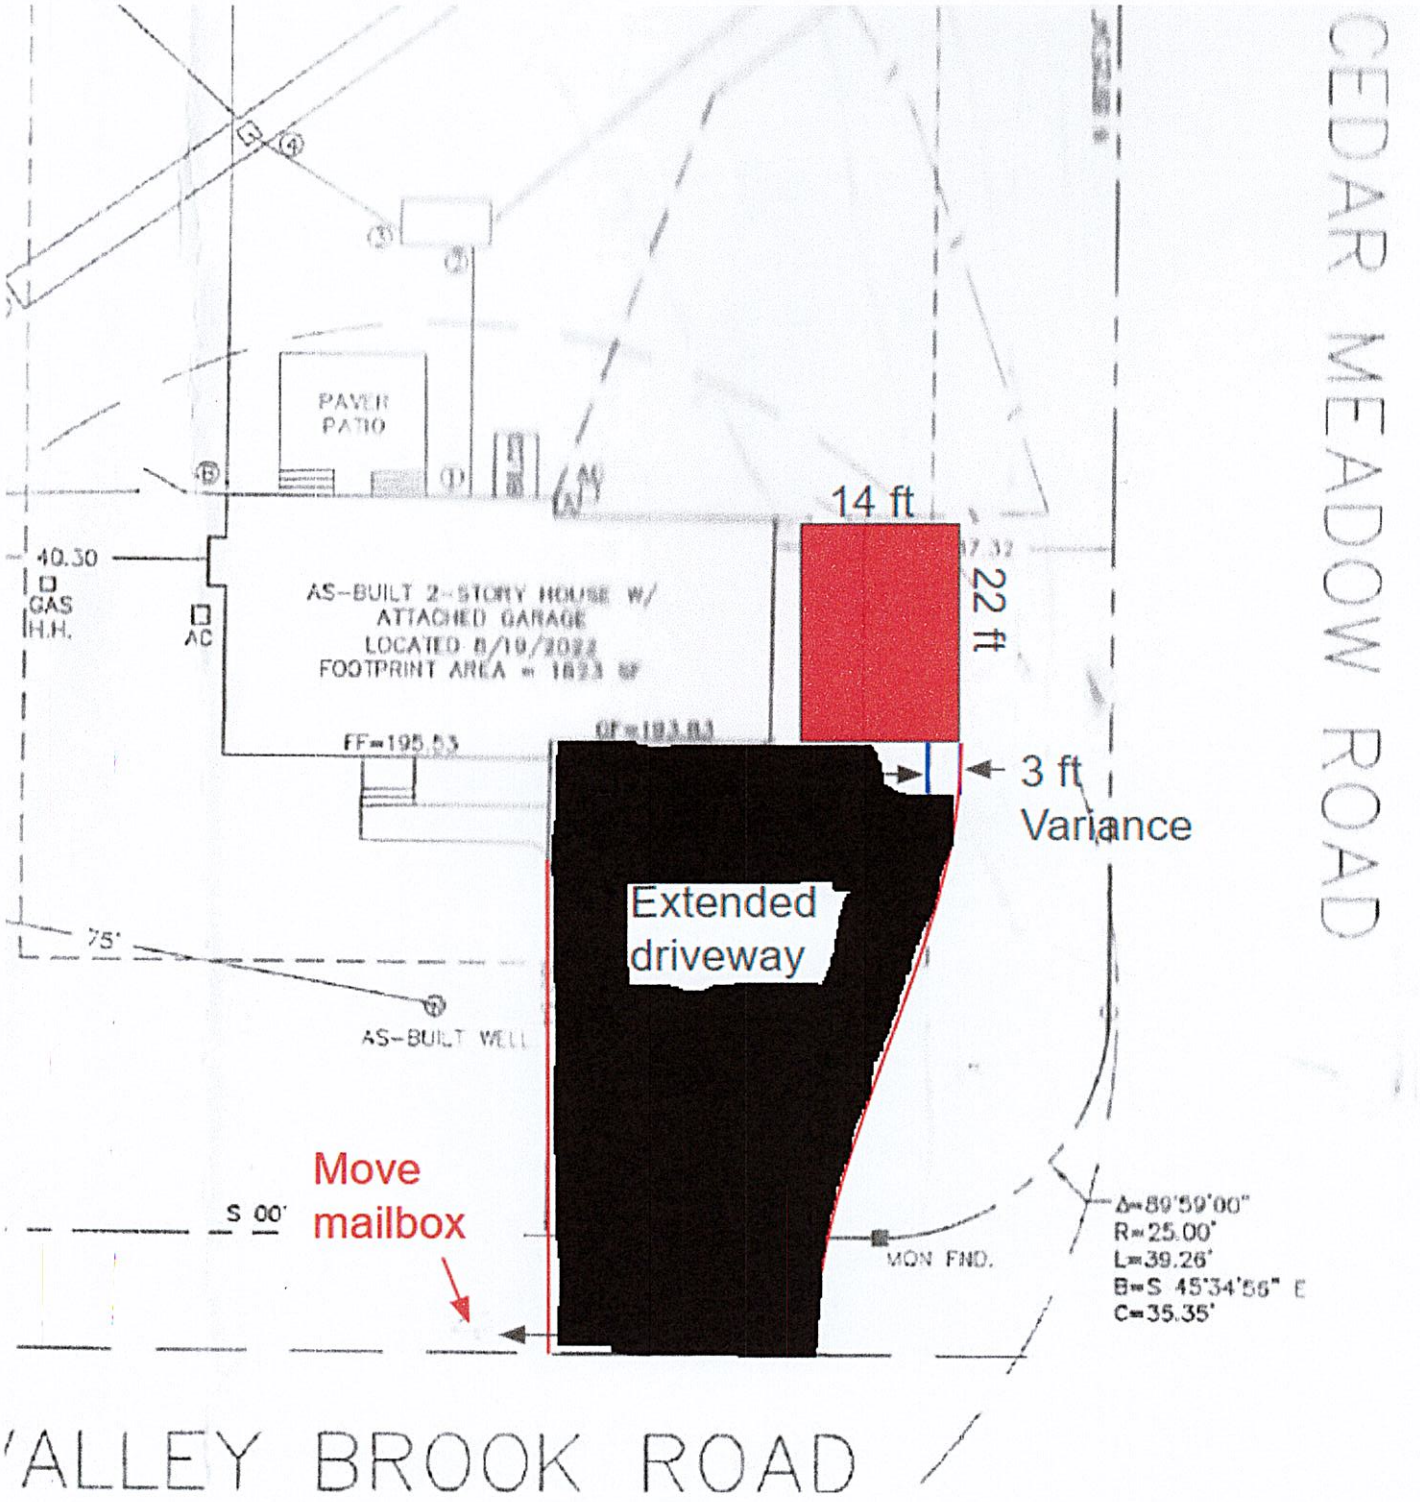

CEDAR MEADOW ROAD
PAVER PATIO
AS-BUILT 2-STORY HOUSE W/ ATTACHED GARAGE
LOCATED 8/19/2022
FOOTPRINT AREA = 1823 SF
40.30
GAS
H.H.
AC
FF=195.53
14 ft
22 ft
3 ft Variance
Extended driveway
75'
AS-BUILT WELL
Move mailbox
S 00°
MON FND.
Δ=89°59'00"
R=25.00'
L=39.26'
B=S 45°34'56" E
C=35.35'
VALLEY BROOK ROAD