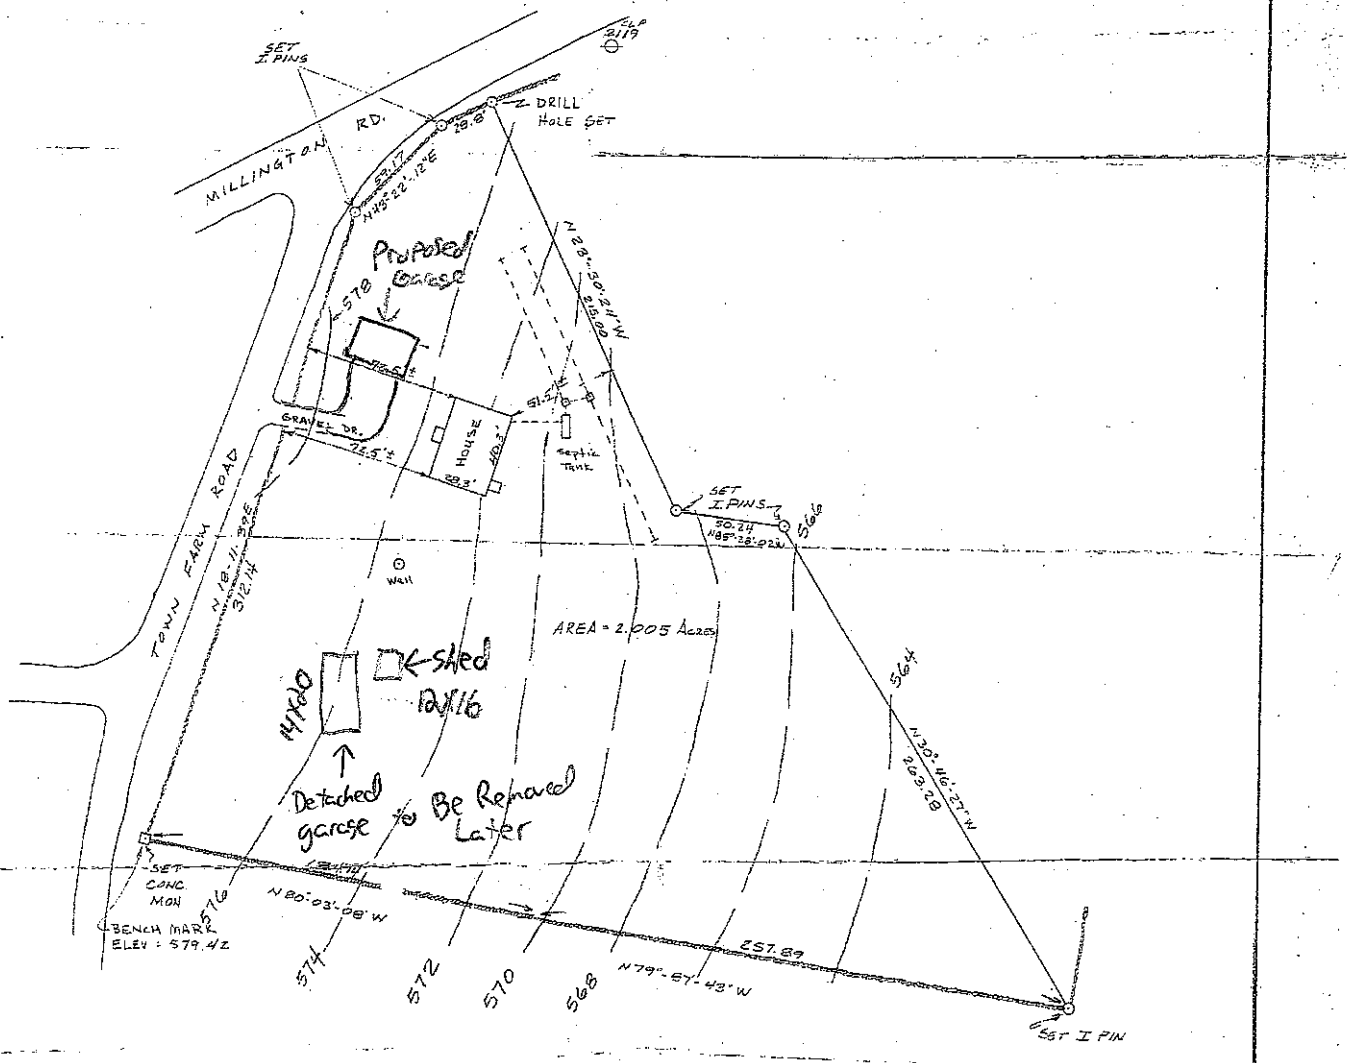


"AS-BUILT"

PLOT PLAN FOR

KYLE ZUPAN

TOWN FARM ROAD

EAST HADDAM, CT

SCALE: 1" = 40' DATE: OCT. 26, 1989

CONTOUR INTERVAL = 2'

STATE OF CONNECTICUT WILLIAM C. BARON NO. 8152 REGISTERED LAND SURVEYOR

approved per town's compliance
Peter Kyle 11/6/89

THIS MAP & SURVEY WERE PREPARED IN ACCORDANCE WITH THE STANDARDS OF A CLASS A-2 SURVEY AS DEFINED IN THE CODE OF PRACTICE FOR STANDARDS OF ACCURACY OF SURVEYS & MAPS.

William C. Baron
L.S. # 8152